
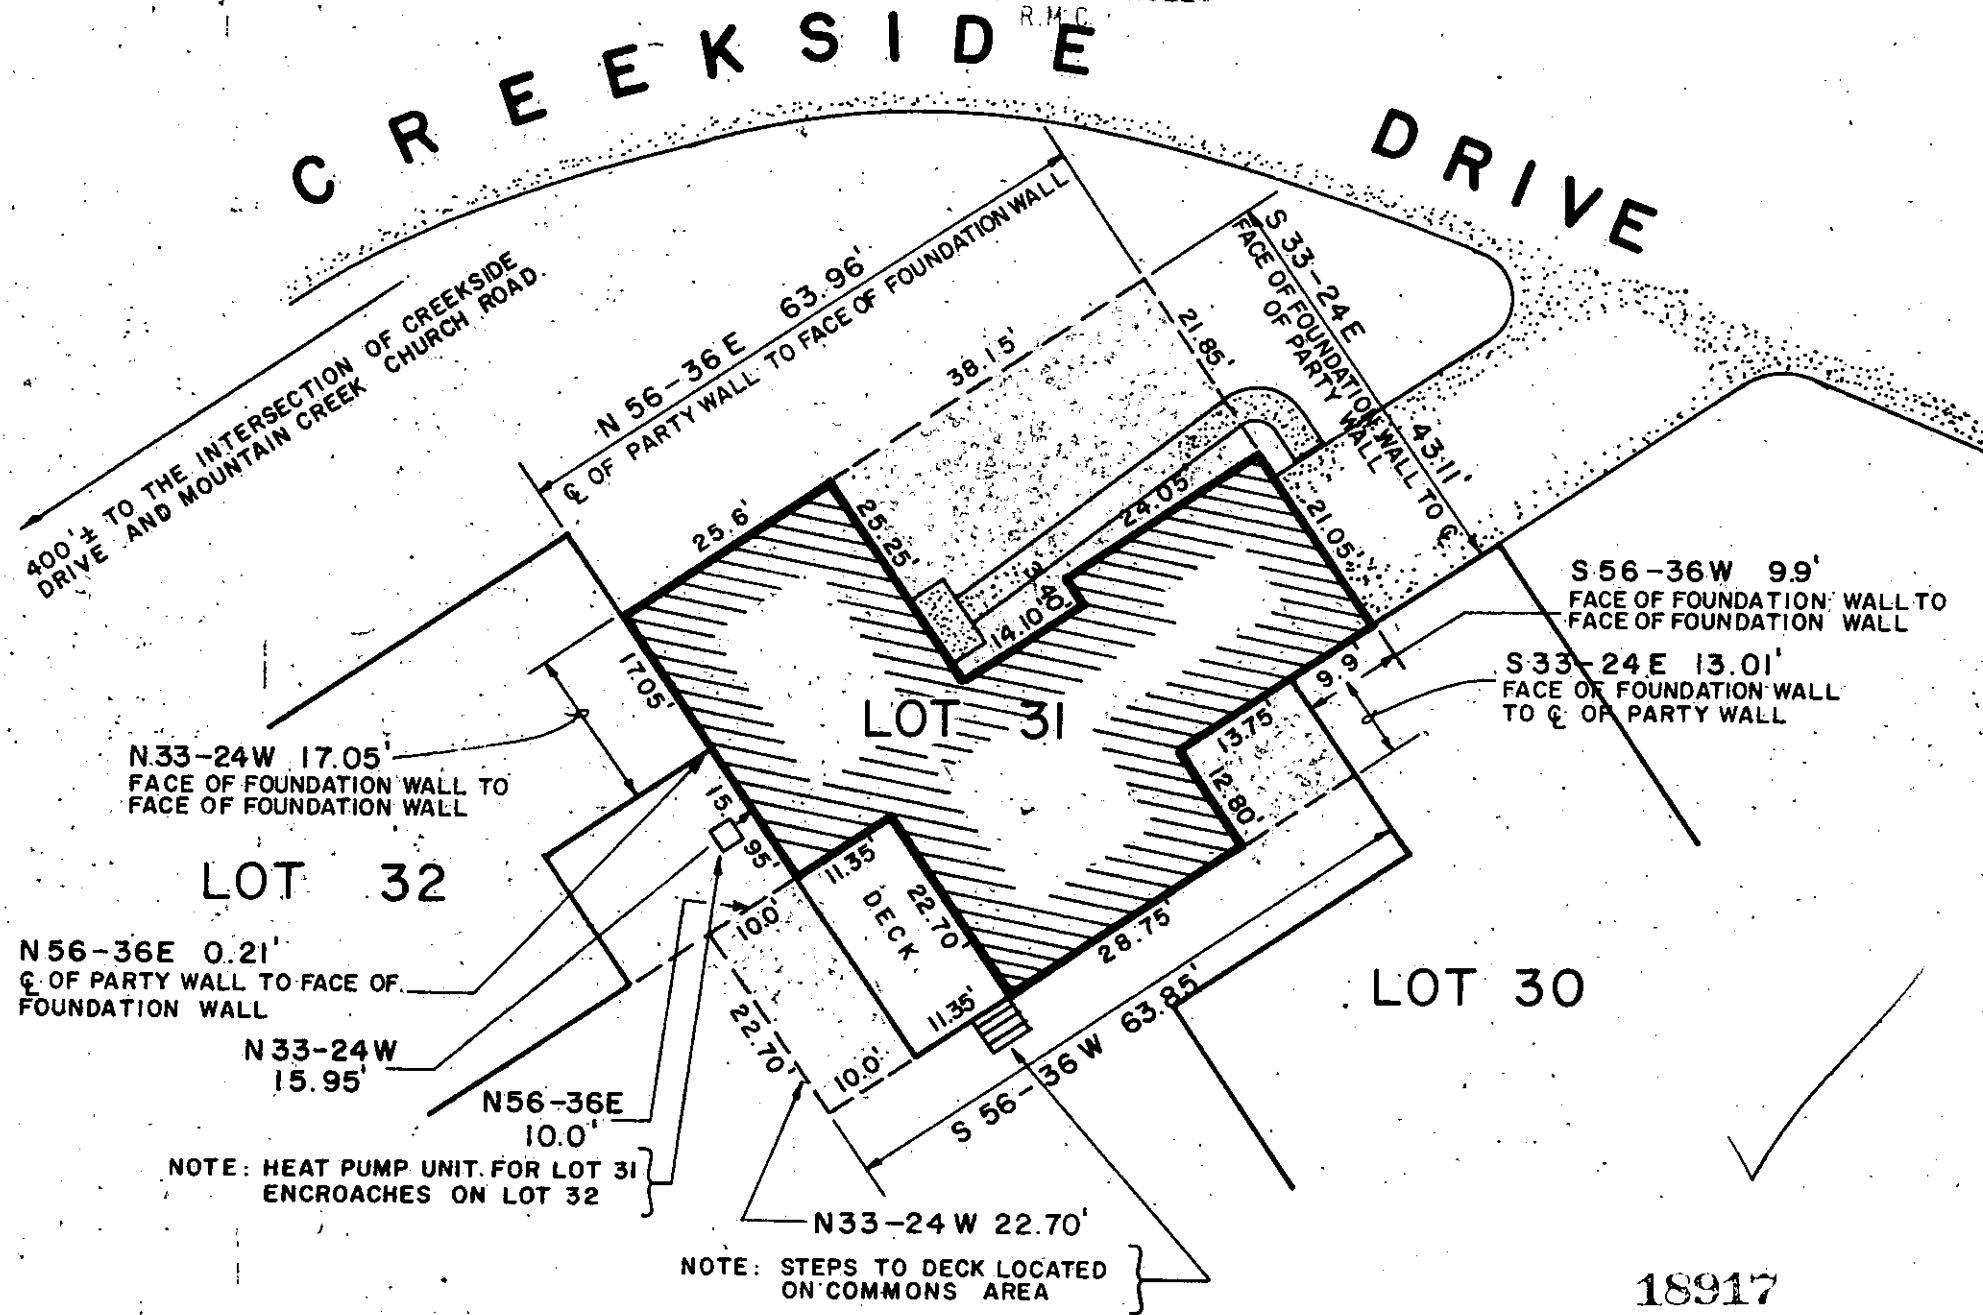
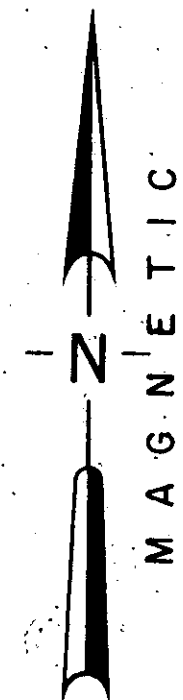


NOTES:

1. ARBOR ENGINEERING, INC. ASSUMES THAT ALL INTERIOR WALLS, ANGLES, AND DIMENSIONS SHOWN ON ARCHITECTURAL DRAWINGS PROVIDE BY THE OWNER ARE THE CONTRACTORS AS BUILT DIMENSIONS UNLESS OTHERWISE SHOWN OR STATED.
2. FOR ALL UNITS WITH A COMMON PARTY WALL, THE CENTER LINE OF THE COMMON PARTY WALL OF THE AS BUILT UNIT IS THE PROPERTY LINE.
3. ALL OTHER PROPERTY LINES ARE EXTENSIONS OF, OR PERPENDICULAR TO THE COMMON WALL PROPERTY LINES, OR ARE EXTENSIONS OF OR RUN WITH THE FACE OF AN EXTERIOR FOUNDATION WALL.

FILED
GREENVILLE CO. S.C.
FEB 23 10 25 AM '82
DONNIE S. TANKERSLEY
R.M.C.

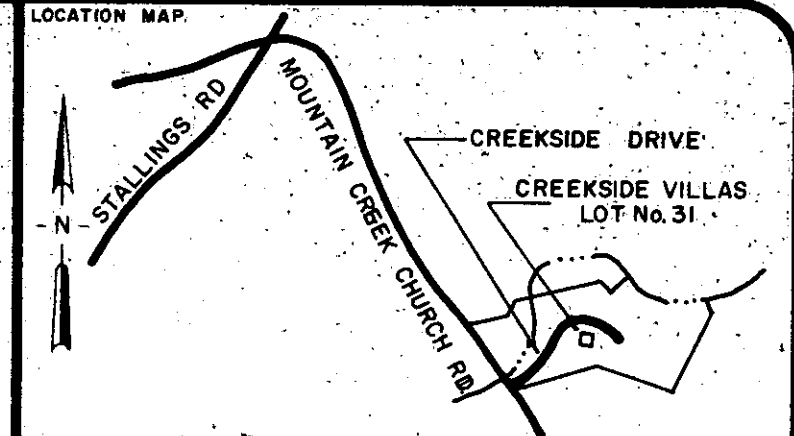

CERTIFICATION:

1. (4) This is to certify that the bearings and distances, and or measurements, shown on this plat are correct, and that all rights of way, easements, and encroachments, obvious and apparent from field observation of the subject property at the time of the survey are as shown.
2. (4) This is to certify that the area of the subject property shown on this plat was computed by the coordinate method of area calculation and that this is a CLASS B survey.
3. (4) The Department of Housing and Urban Development Flood Way Data for Greenville County shows this property () to be in a flood plain, () not to be in a flood plain, () location cannot be determined.

William N. Gladwin
SIGNATURE OF REGISTERED LAND SURVEYOR DATE 2/23/82 S.C. REG. NO. 7261

REFERENCES

| | | |
|----------|-------------|--------------|
| PB 8P-53 | DB | BB |
| PB | DB 1147-548 | BB P22-2-4.3 |
| PB 8N-25 | DB | BB |
| PB | DB | BB |

REVISIONS AND RECERTIFICATIONS

| NO. | BY | DATE | DESCRIPTION | JOB NO. REFERENCE | APPROVED |
|-----|-----|---------|---------------|-------------------|----------|
| 1 | WNS | 19FEB82 | REVISED BOUND | | WNS |
| 2 | WNS | 22FEB82 | REVISED NOTES | | WNS |

**PROPERTY SURVEY FOR
MICHAEL J. MAGRINO
AND NANCY J. MAGRINO**
LOT No. 31
CREEKSIDE VILLAS P.U.D.
PHASE I
GREENVILLE SOUTH CAROLINA

SCALE 0 20 40

| | | | |
|--------------|---------------|---------------|------------------|
| RESEARCH TAG | DRAWN WNS | CHECK WCM | DATE 18 FEB 1982 |
| FILE | FIELD WORK BY | JOB NO. 82027 | |

ARBOR ENGINEERING
P.O. BOX 263, GREENVILLE, S.C.
LANDSCAPE ARCHITECTS-ENGINEERS-LAND SURVEYORS

8-V-94

18917

FEB 23 1982