FILED
GREENVILLE CO. S. C.
APR 4 11 52 AM '77
DONNIE S. TANKERSLEY
R.M.C

CENTERLINES AND BOUNDARIES

NO.	△ OR BRG.	DIST. OR RAD	ARC	NO.	△ OR BRG.	DIST. OR RAD	ARC
A	14°42'42"	409.26	105.08				
B	S54°01'00"E	72.76		E	S61°00'10"E	50.37	
C	N35°59'00"E	10.07		F	08°54'01"	250.00	38.85

TRACTS

TRACT	NO.	△ OR BRG	RAD OR DIST	ARC
D	1	68°45'18"	50.00	60.00
D	2	87°50'05"	50.00	76.65

LOTS

BLOCK	LOT	NO.	△ OR BRG.	DIST. OR RAD	ARC	NO.	△ OR BRG.	DIST. OR RAD	ARC
						1	S04°40'25"E	72.87	
1	7	2	S56°09'00"W	36.86					
1	8					1	N06°44'00"W	35.18	
1	16	1	S51°12'E	16.84					
1									
1									
1									
1									
1									
1									
1	24	1	N65°51'E	35.68					
1	25					1	14°42'42"	384.26	98.66
1	25	2	S53°42'E	23.29		3	S11°53'36"E	37.07	
1	25	4	26°53'04"	274.11	128.62				
1	26	1	10°27'04"	274.11	50.00				
1	50	1	S31°30'50"E	66.74		2	N18°56'00"E	95.19	
1	50	3	19°51'26"	274.11	95.00				
1	49	1	N26°26'00"E	10.00		2	21°27'08"	274.11	102.63
1	48	1	N22°24'45"E	35.75					
1	46	1	01°47'21"	384.26	12.00				
1	45	1	20°59'07"	384.26	140.74				
1	44	1	N80°18'00"E	55.00		2	13°21'32"	384.26	89.59
1	53	1	25°32'26"	311.48	138.85				
1	51	1	19°51'26"	274.11	95.00				

REV.	DATE	BY	DESCRIPTION	APP.
◇				
◇				
1	4-4-77	WNS	CORRECTIONS TO LOTS 51,52,&53; LOTS 14&15; LOT 19, LOT 25 & REFERENCE DATA BLOCK	G.W.O.

REVISION

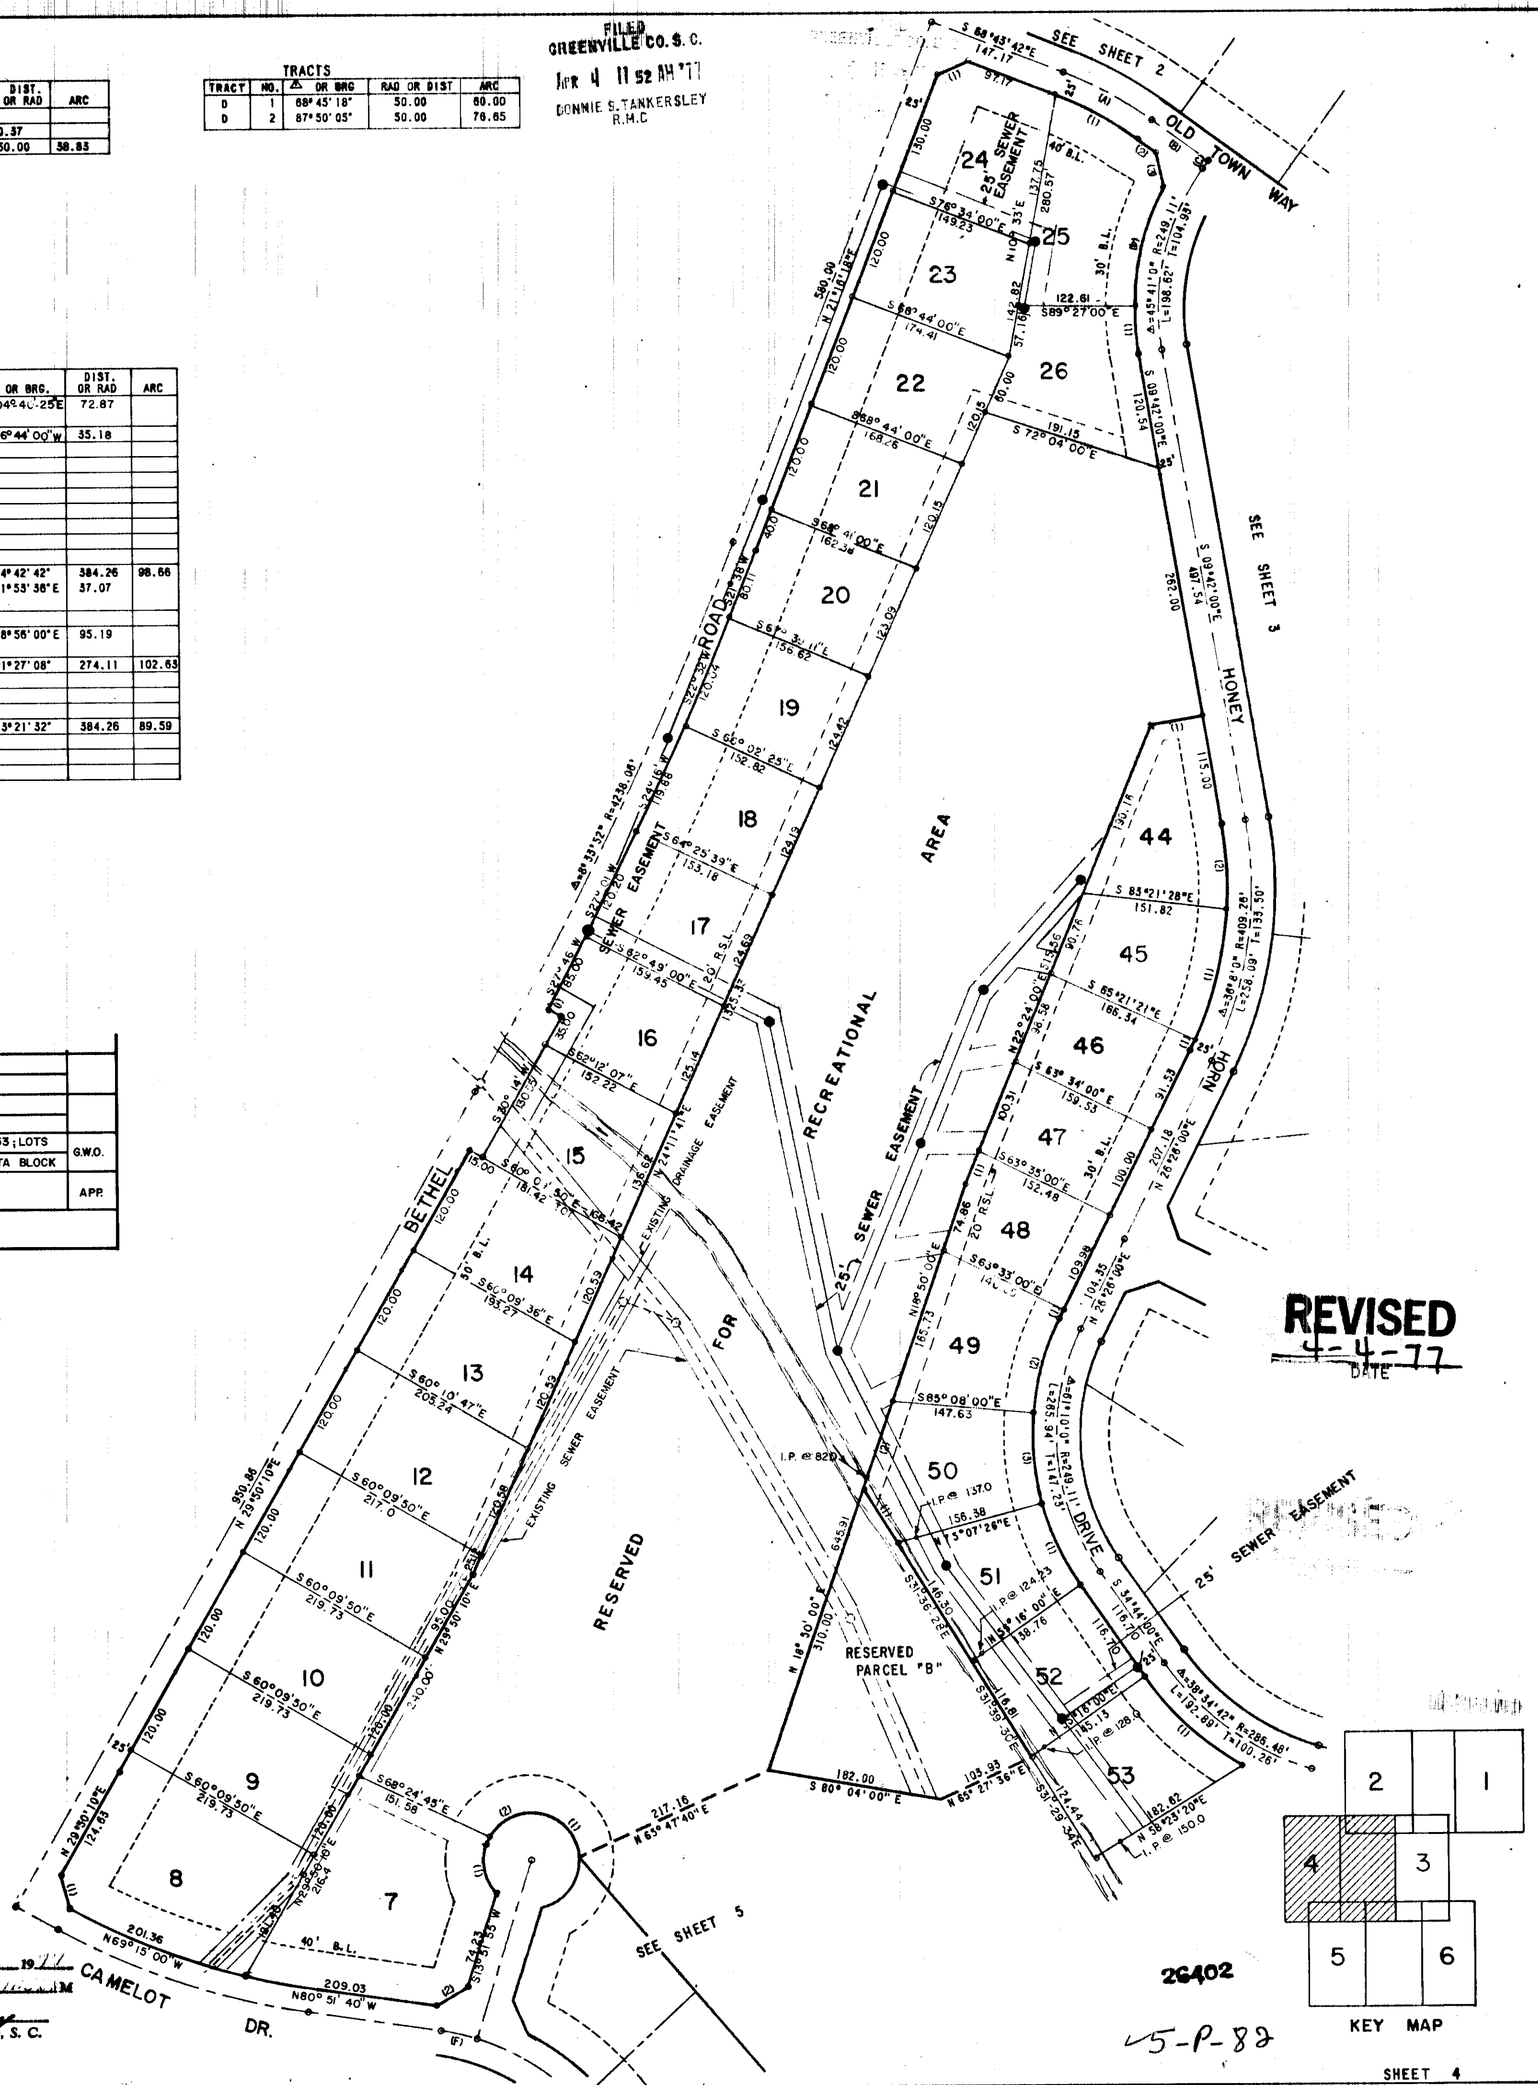

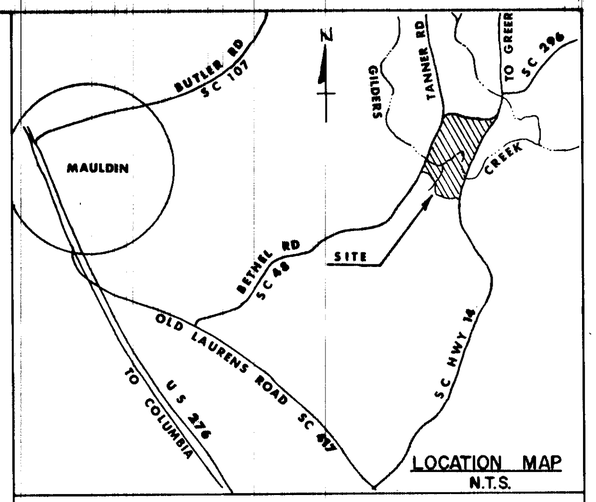

CERTIFICATE OF ACCURACY

"I, B.P. Jenkins, certify that this plan was ~~(drawn by me)~~ (drawn under my supervision) ~~(an actual survey made under my supervision)~~ from (an actual survey made by me) (Deed description recorded in Book _____, Page _____, Book _____, Page _____, etc.) (Other); that the error of closure as calculated by latitudes and departures is 1:8000, that the boundaries not surveyed are shown as broken lines plotted from information found in Book _____, Page _____, that this plan was prepared in accordance with the Greenville County Subdivision Regulations as adopted".

5-28-73
Date

B. Patrick Jenkins
Licensed Engineer or Registered Surveyor

South Carolina Registration No. 3531

CERTIFICATE OF OWNERSHIP AND DEDICATION

"The undersigned hereby acknowledge that I am (We are) the Owner(s) of the property shown and described hereon and that I (We) hereby adopt this plan of subdivision with my (our) free consent and that I (We) establish the minimum Building Restriction Lines and hereby dedicate to public use as roads, streets, and easements, forever all areas so shown or indicated on said plat".

Signed _____
Signed _____
Signed _____
Signed _____

CERTIFICATE OF APPROVAL FOR RECORDING

"I hereby certify that the Subdivision plan shown hereon has been found to comply with the subdivision regulations for Greenville County, with the exception of such variances, if any, as are noted in the Minutes of the Greenville County Planning Commission of Greenville County, South Carolina, and that it has been approved for recording in the Office of the County Register of Mesne Conveyance."

4-4, 1977

Chairman, Secretary, or Director of Planning Greenville County Planning Commission

FILE NUMBER

FINAL PLAT 72-166

HOLLY TREE PLANTATION

MAULDIN — SOUTH CAROLINA

JACK E. SHAW
DR. JAMES P. McNAMARA
JOHN A. GERRING
OWNERS:

enwright associates, inc.
ENGINEERS · SURVEYORS · PLANNERS
HAYWOOD ROAD POST OFFICE BOX 5267
GREENVILLE, SOUTH CAROLINA 29606

NO. OF ACRES 14.982 — MILES OF NEW ROADS 0

NO. OF LOTS 30 — DATE 5/28/73

ERROR OF CLOSURE 1:8,000

72097-(C)4 of 6
DWG.

SCALE: 1" = 100' (0 — 100' — 200')

Plat Filed This 4 day of April 1977
And Recorded in Vol. 5-P Page 84 at ____ M
Donnie S. Tankersley
Register Mesne Conveyance Greenville County, S. C.

2G402

5-P-82