FILED
GREENVILLE CO. S. C.
AUG 5 2 03 PM '80
DONNIE S. TANKERSLEY
R.M.C

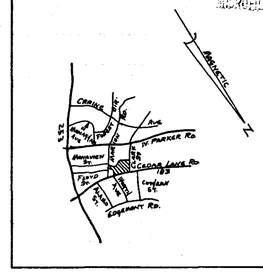


KEY MAP
N.T.S.

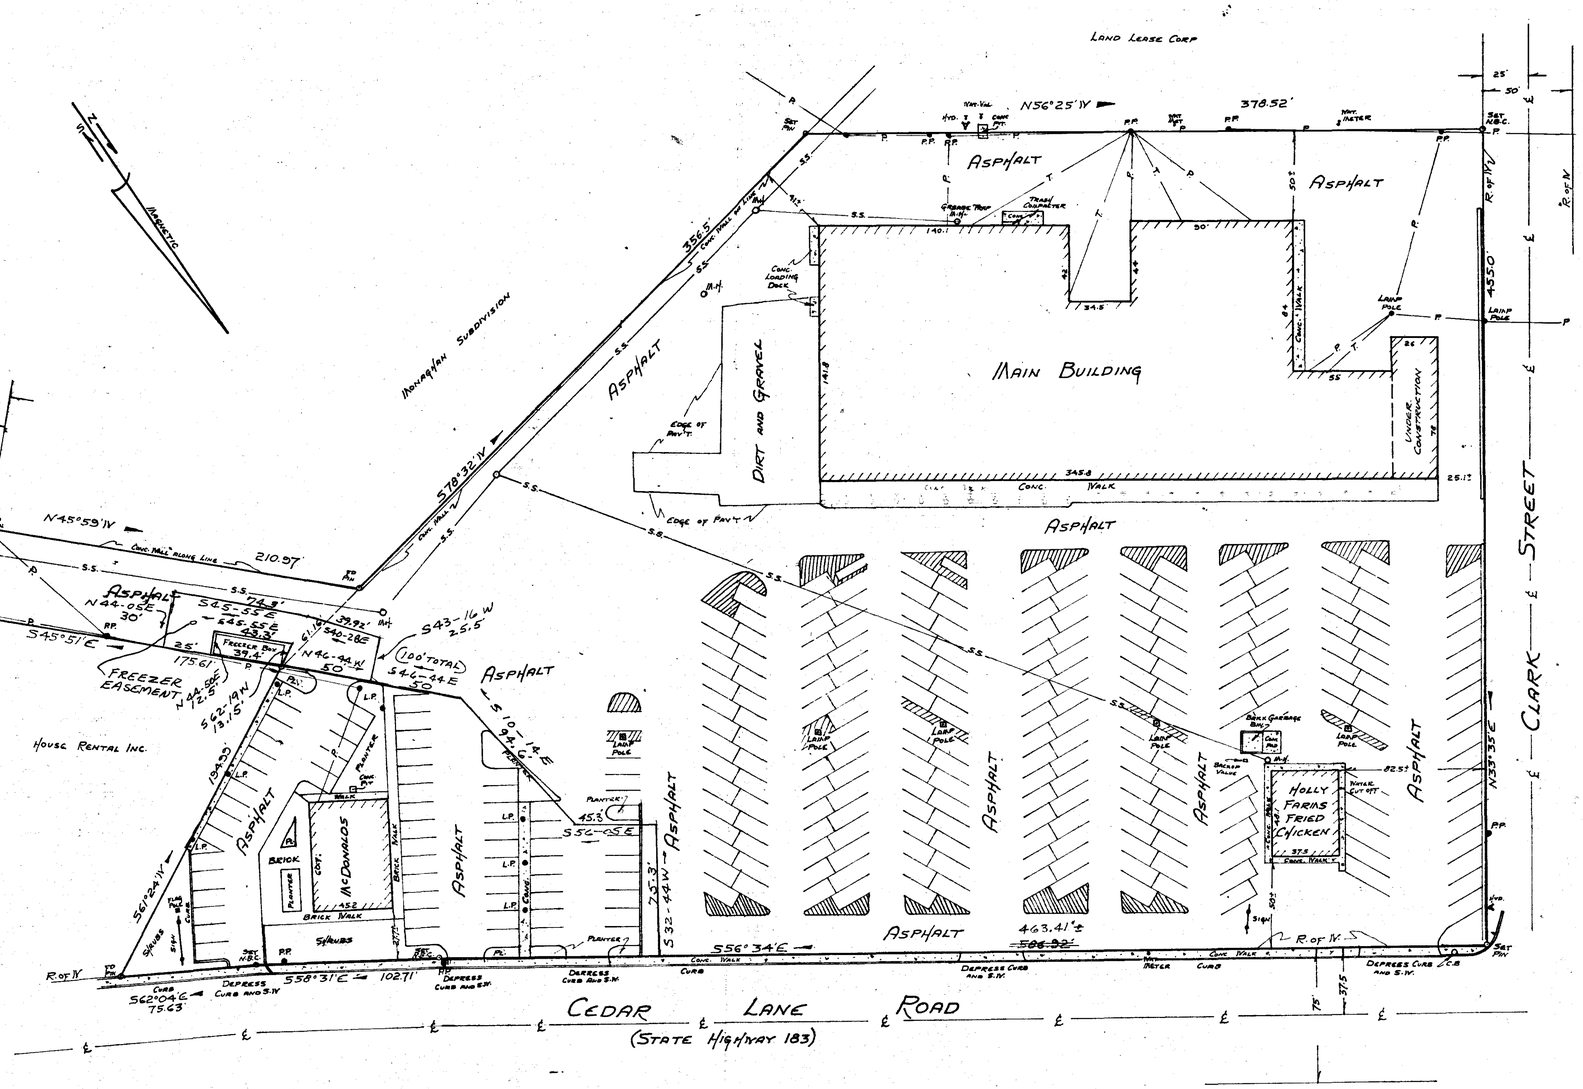


THIS PLAT IS [illegible] SUBDIVISION AND [illegible] WITH OR [illegible] COUNTY SUBDIVISION REGULATIONS.
8/5 F.J. Forbes
Chairman, Secretary, or Director of Planning.
Greenville County Planning Commission

# Final As Built Survey for Land Lease Corp.

Near Greenville, South Carolina
Scale 1"=40' Nov. 16, 1976

NOTE:
TRACT FOR McDONALDS CORPORATION ADDED JUNE 23, 1980 - NO FIELD SURVEY MADE - DESCRIPTION TAKEN FROM TOPOGRAPHICAL MAP FOR McDONALDS CORP. DATED MAY 1979 BY DALTON & NEEVES CO. ENGR. - BEARINGS CONVERTED TO SAME MAGNETIC DATUM AS LAND LEASE PLAT.

BY: CLARKSON SURVEYING
H.C. Clarkson Jr. SCRLS 2589

3432
7-Y-60

6.45 Ac.
0.765 SITE (McDONALDS)
5.685
0.012 FREEZER
5.673
0.065 FREEZER EASEMENT
5.608

Graphic Scale
40 30 20 0 40 80 120 160

## Certificate

This is to certify that on Nov 16, 1976, I surveyed the property on this plat, and the same is correct, being the same property as described in deed recorded in Deed Book 361 on Page 656, office of R.M.C. for Greenville County, South Carolina.

That the dimensions of the new structure are as shown on said plat, and the improvements are within the lot lines and that no restrictive building lines have been violated.

That there are no easements or encroachments or utilities crossing, except as shown hereon.

R D Weston Jr.
Reg. Land Surveyor
No 4678

AUG 5 1980

3432
7-Y-61

By Campbell & Clarkson
Surveyors, Inc.
R D Weston
S.C.R.L.S No 4678

54-G

Bk 163 Pg 66-75

GCTD --- 1 AU 5 80 434
GCTD --- 1 AU 5 80 442
5.00 CI
5.00 CI